
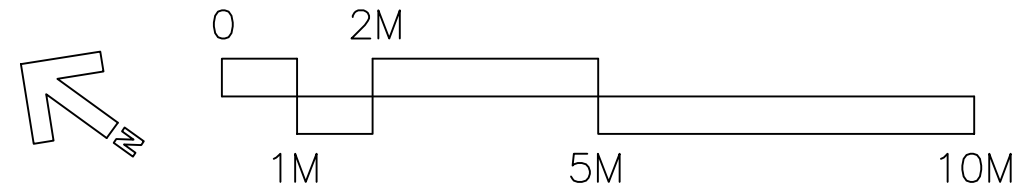


SPACE UTILISATION LEGEND (USABLE AREAS)

HATCH PATTERN REPRESENTS SCHOOL
INSET LETTER REPRESENTS DEPARTMENT

PSYCH

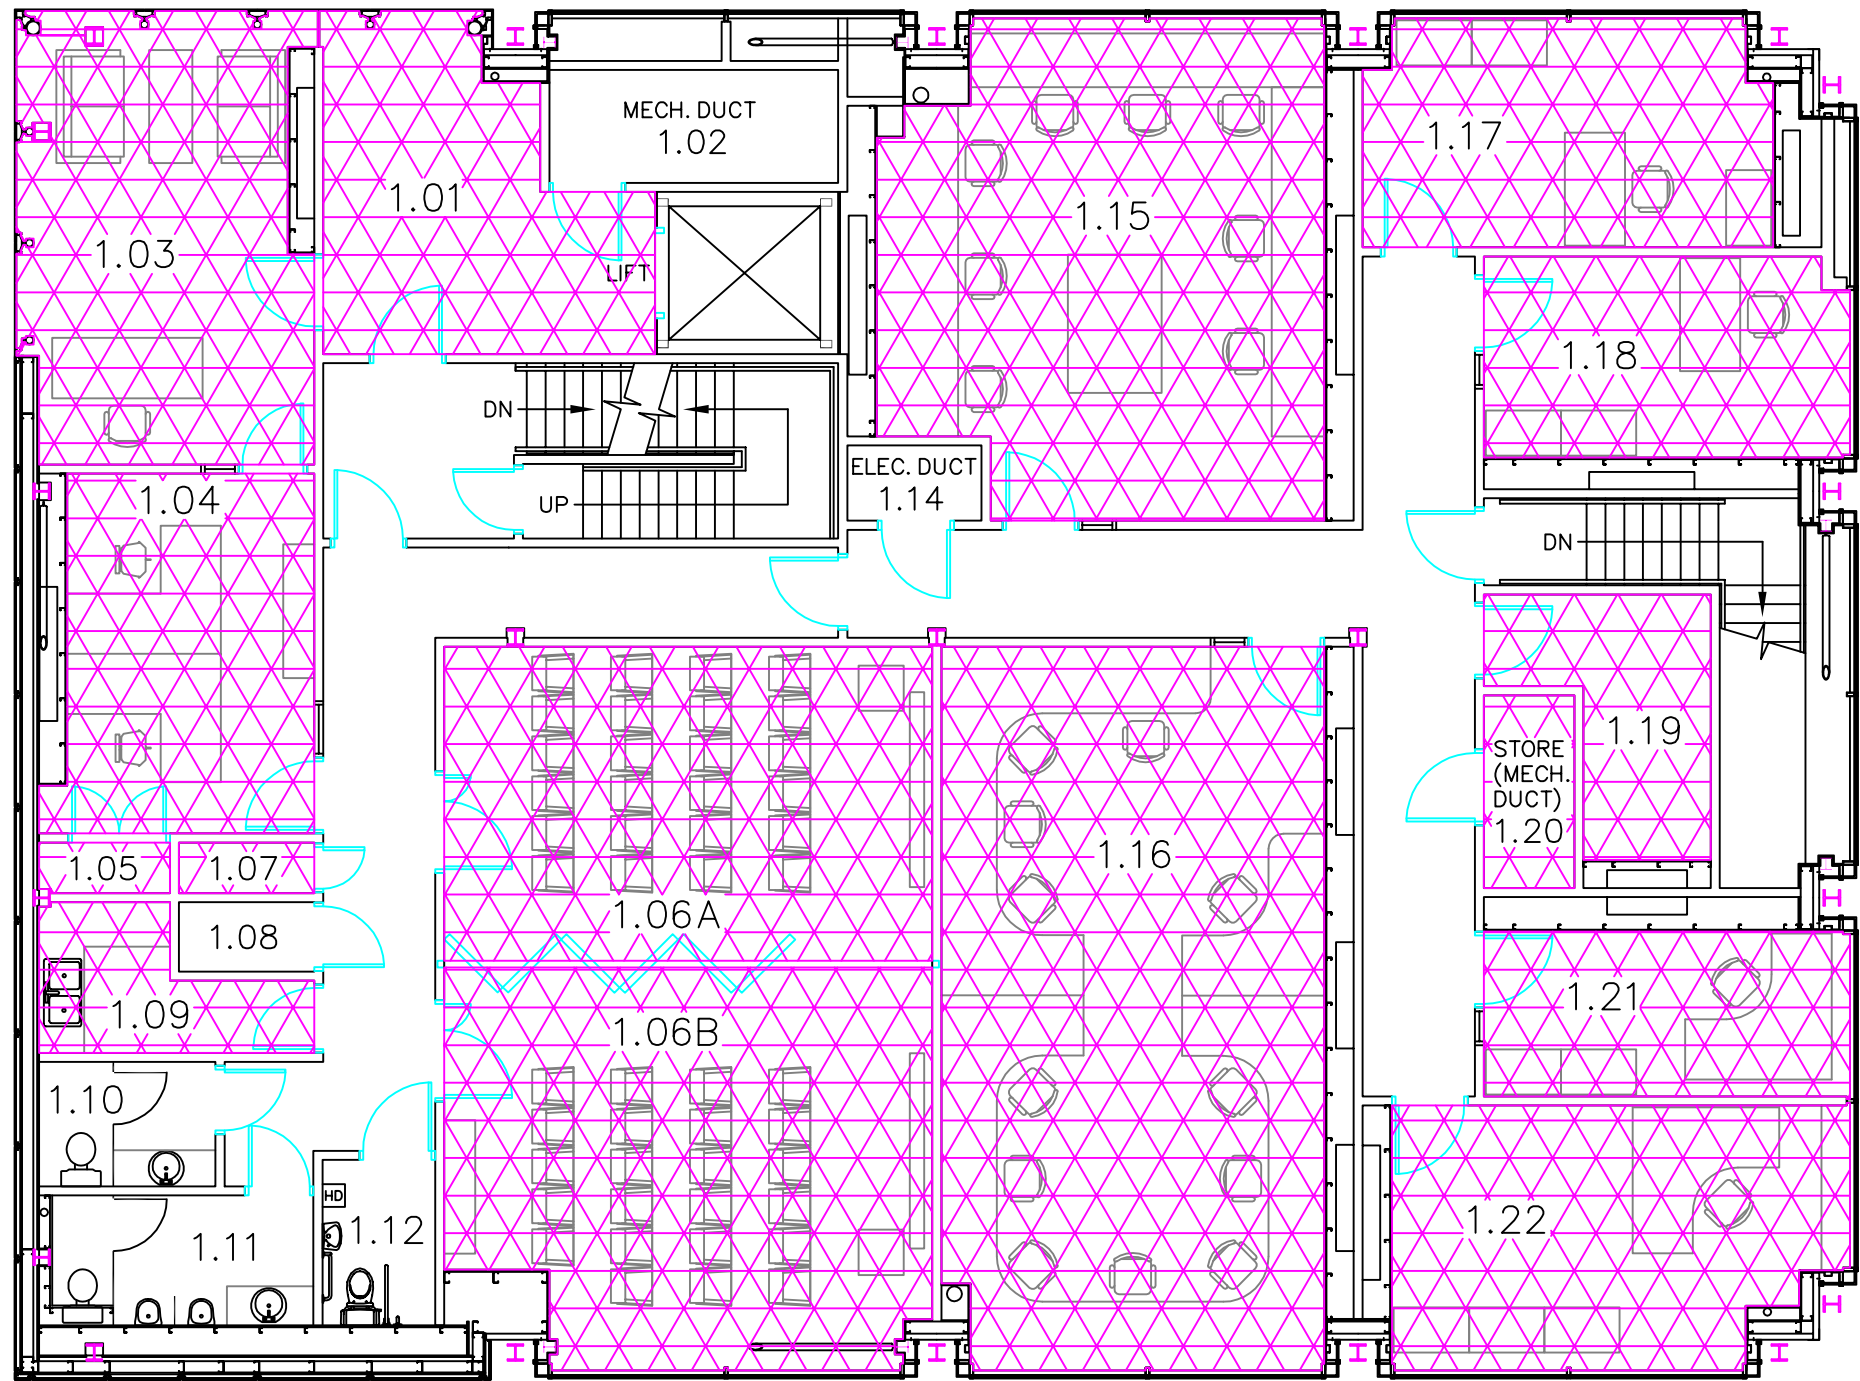

USABLE LAYOUT.
LAST UPDATED – 17/10/2006
DETAILS SUPPLIED BY – RLF
DRAWN BY – RLF

ESTATES DIVISION

CARDIFF
UNIVERSITY
PRIFYSGOL
CARDIFF

TITLE
CUBRIC BUILDING.
FIRST FLOOR PLAN.

LAYOUT OF USABLE SPACE.

| | |
|-----------------------------|--|
| SCALE 1:100\A3 SHEET | ORIGINAL LAYOUT DRAWN: NOEL ARCH.\RLF |
| LAST REVISED: DRAWN/DATE | JAS - 17/03/2008 |
| REC. DWG. No. | AR\VAR09\FP\01 |

RECORD DRAWING